




NORTH ELEVATION
SCALE 1:100
(as built)

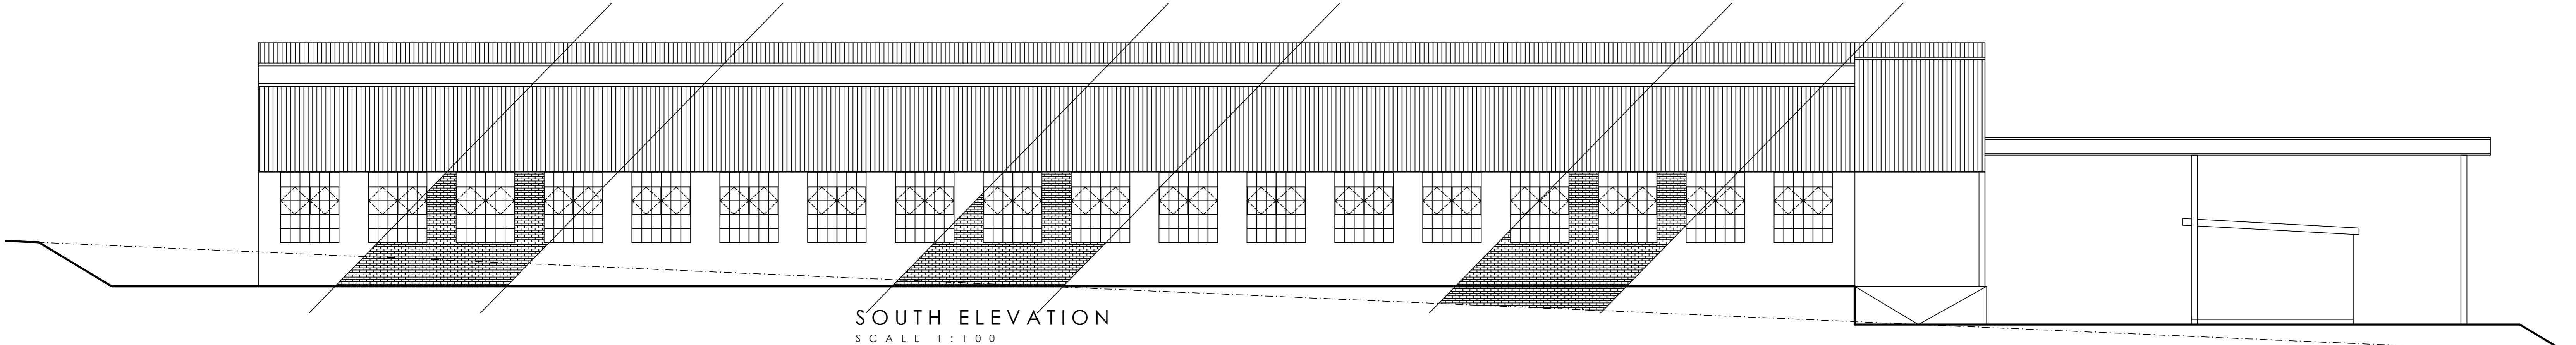


SOUTH ELEVATION
SCALE 1:100

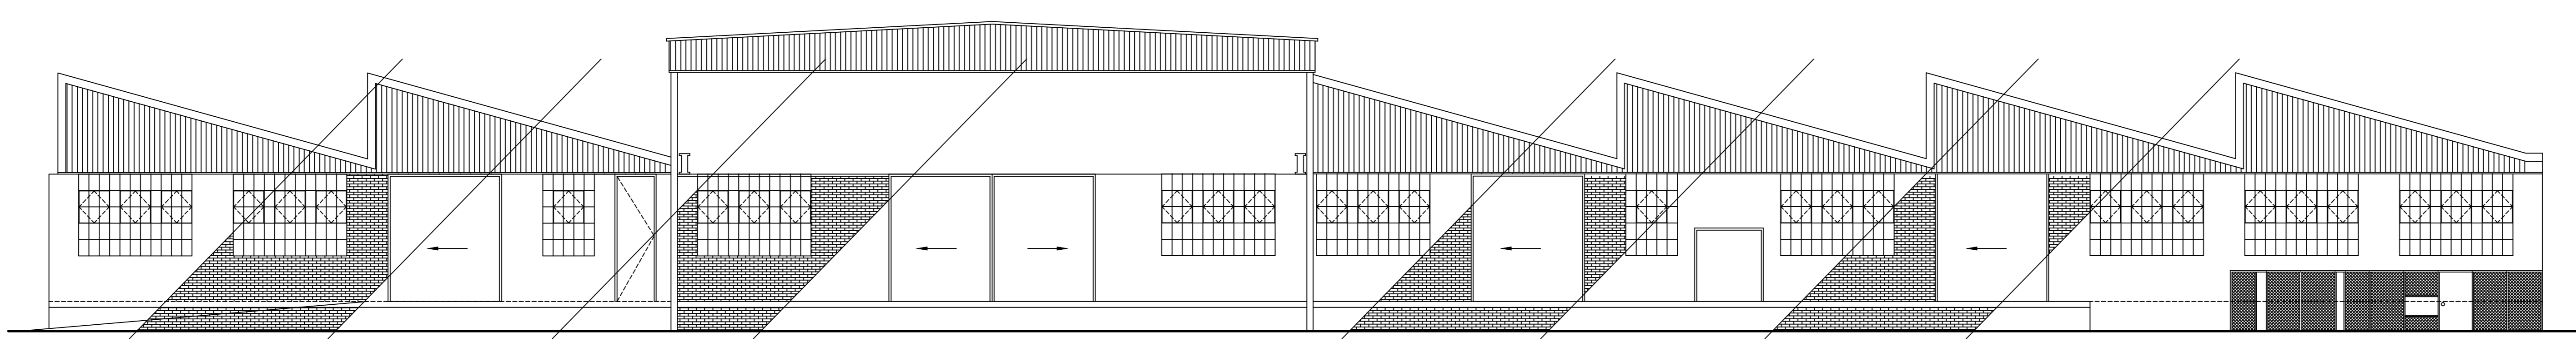


EAST ELEVATION
SCALE 1:100
(as built)

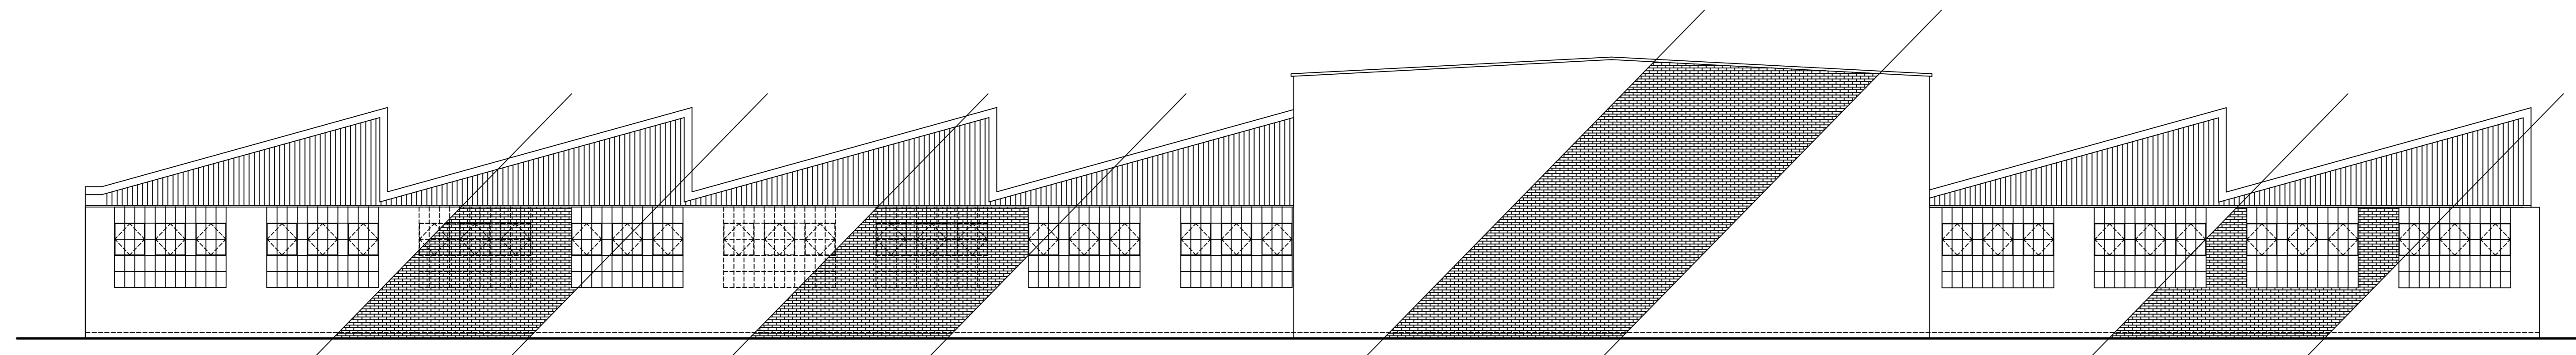


WEST ELEVATION
SCALE 1:100
(as built)

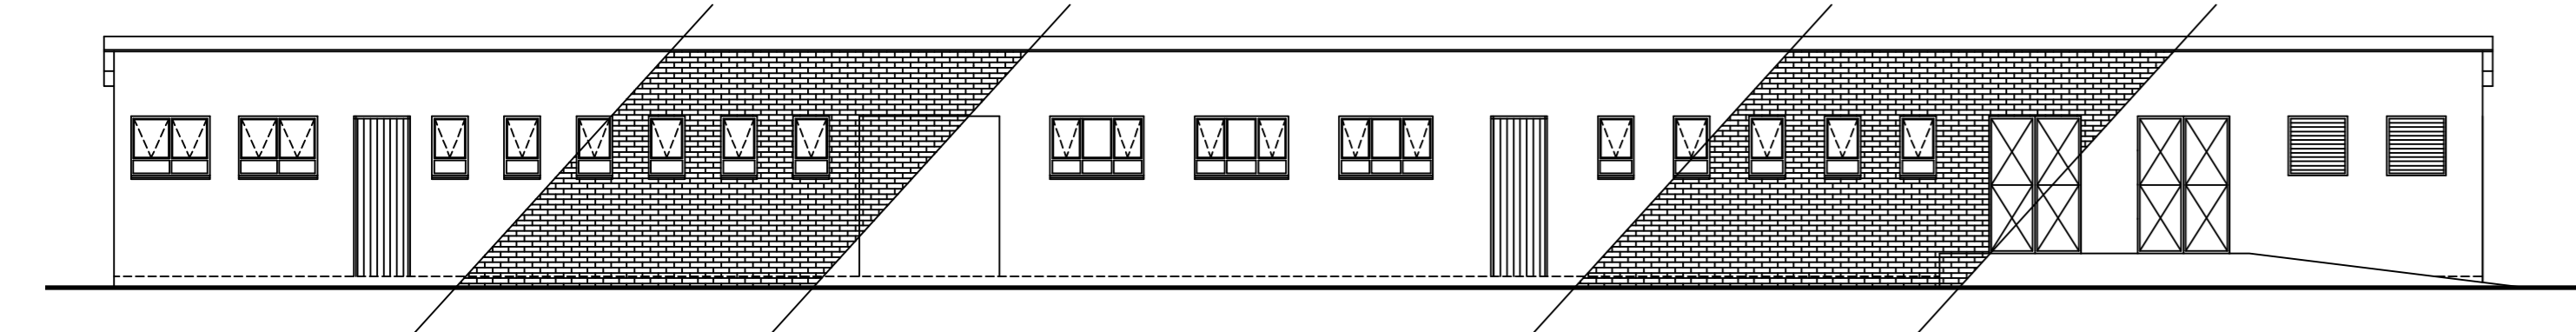


WEST ELEVATION
SCALE 1:100
(as built)

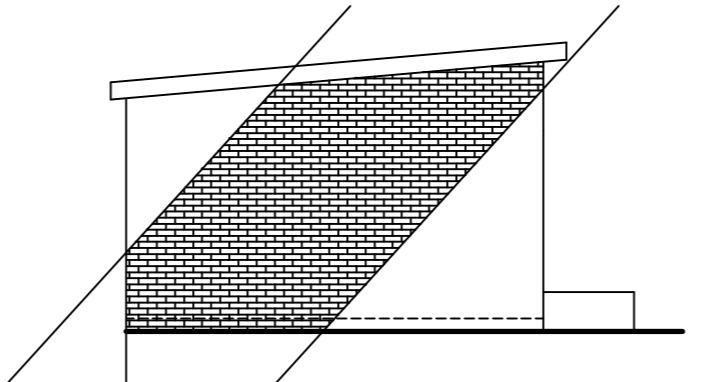


NORTH ELEVATION
SCALE 1:100
(as built)

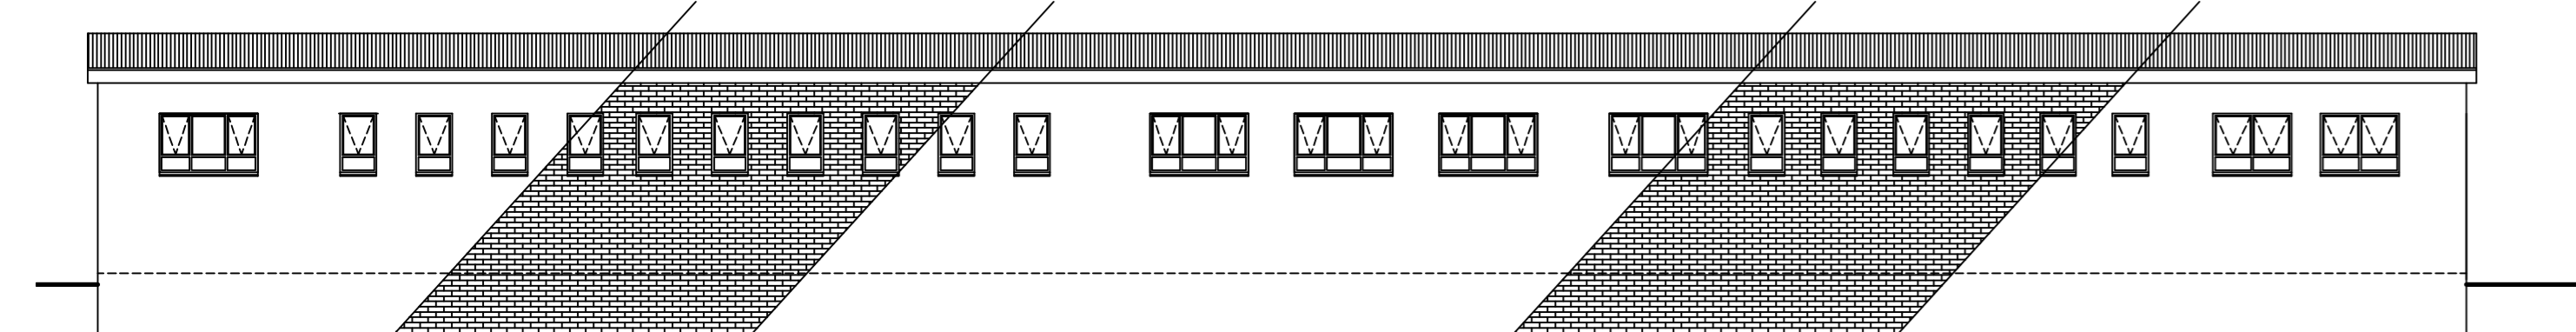

EAST ELEVATION
SCALE 1:100
(as built)

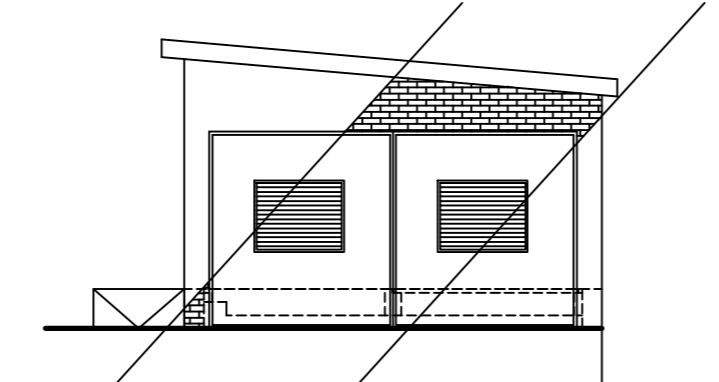

SOUTH ELEVATION
SCALE 1:100
(as built)

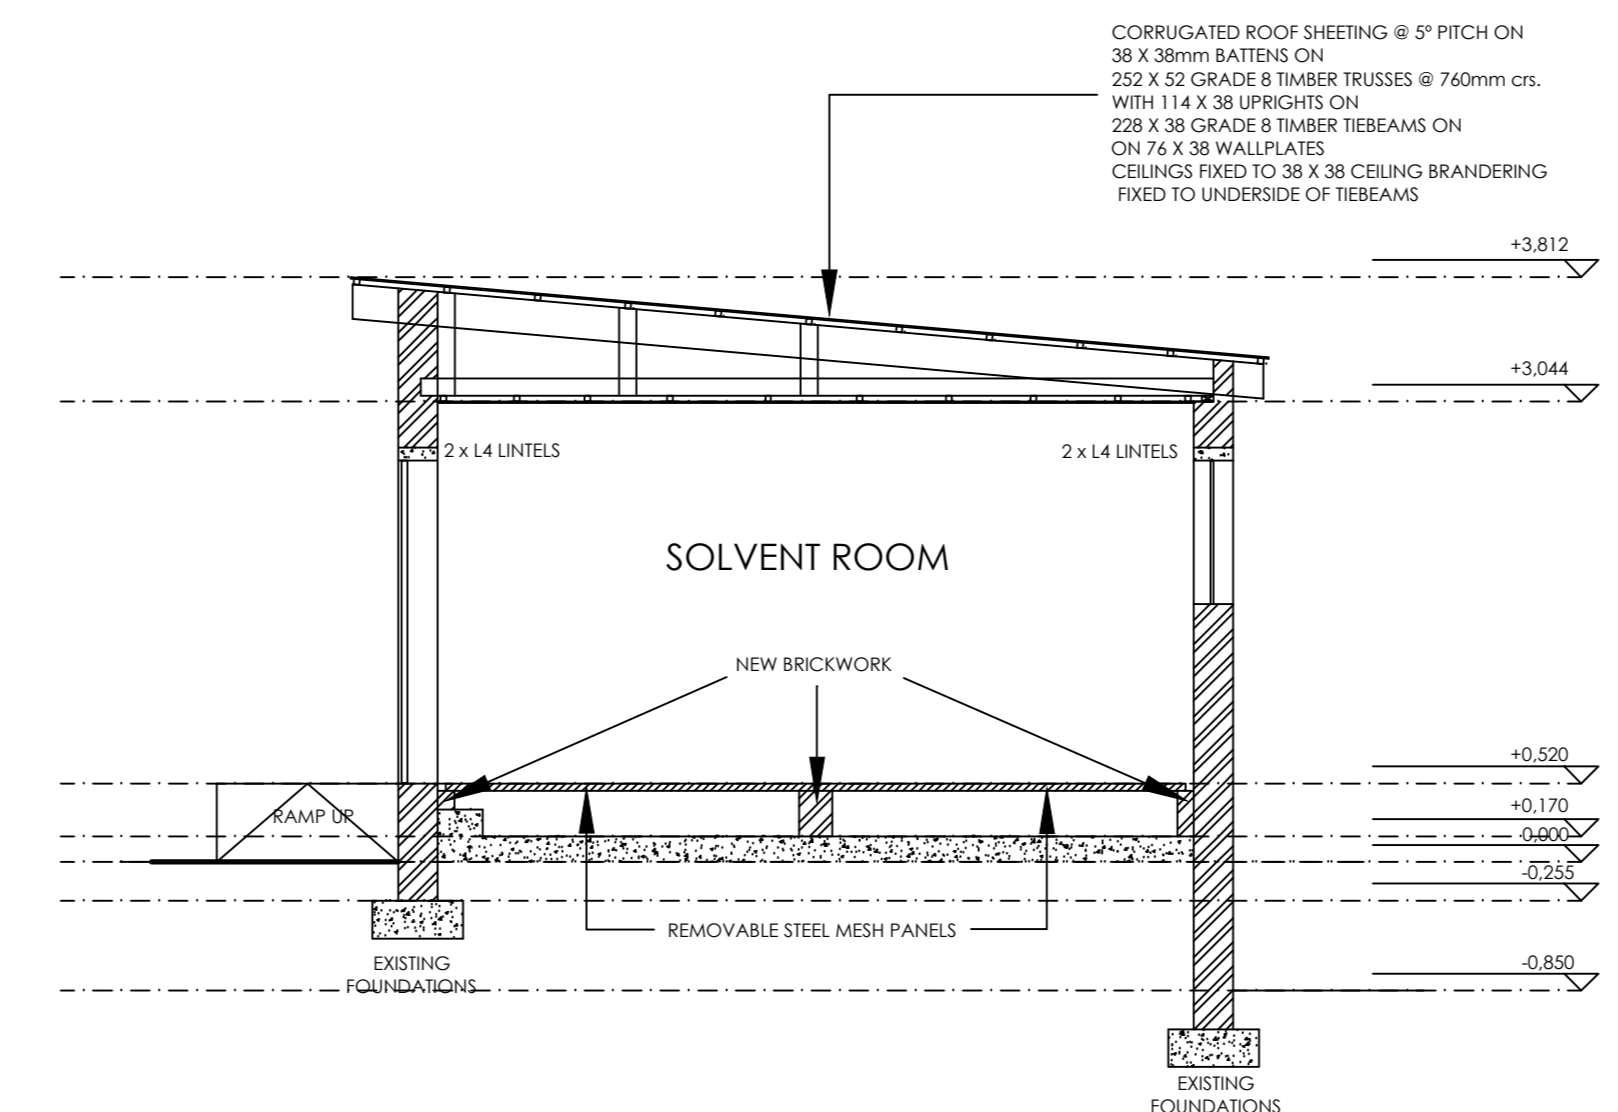

SECTION B-B

GENERAL NOTES
 QUALITY OF ALL MATERIALS AND WORKMANSHIP TO COMPLY WITH THE RELEVANT NATIONAL BUILDING REGULATIONS & SPECIFICATIONS. CONTRACTORS TO VERIFY ALL LEVELS, HEIGHTS AND DIMENSIONS ON SITE AND TO CHECK SAME AGAINST THE DRAWINGS BEFORE PUTTING ANY WORK IN HAND. ALL CONTRACTORS TO CHECK THE DETAILS SHOWN ON THIS DRAWING FOR COMPLIANCE WITH STANDARDS OF GOOD BUILDING PRACTICE WITH PARTICULAR REFERENCE TO SPECIAL REQUIREMENTS NECESSARY BY LOCAL AND/OR ON SITE CONDITIONS AND TO REPORT ANY COMMENT TO THE ARCHITECT/DESIGNERS. CONTRACTORS ARE TO ENSURE THAT ALL DETAILS SHOWN IN THIS DRAWING ARE IN COMPLIANCE WITH NATIONAL BUILDING REGULATIONS. CONTRACTORS ARE TO LOCATE AND IDENTIFY EXISTING SERVICES ON SITE AND TO PROTECT THESE FROM DAMAGE THROUGHOUT THE DURATION OF THE WORKS. ANY DISCREPANCIES OR OMISSIONS TO BE REPORTED TO THE ARCHITECT/DESIGNERS IMMEDIATELY.
 ANY QUERIES ARISING FROM ALL THE ABOVE MUST BE REPORTED TO THE ARCHITECT/DESIGNERS FOR CLARIFICATION BEFORE ANY WORK IS PUT IN HAND. DIMENSIONS IN THIS DRAWING ARE TO BE USED AT ALL TIMES.

SPECIAL NOTE
 REGARDING SPECIALIST WORK, E.G. SHORFITTING, CEILING AND SIGNAGE, IT IS IMPLIED THAT IN THE ABSENCE OF FINISH DETAILS SUCH CONTRACTORS MUST USE DUE DILIGENCE REGARDING ALL ASPECTS OF THEIR OWN TRADE WITH SPECIFIC REFERENCE TO THE SAFETY OF SUCH CONSTRUCTION AND EXECUTION.

REVISIONS

NO.	DATE	DETAILS

Croft Projects
 architectural design and planning
 P.O. Box 3861
 DAINFERN 2035
 CELL: (072) 595 1740
 FAX: (086) 529 0303
 e-mail: errol@croftprojects.co.za

PROJECT:

MR. B. MUIR
 AEROTRONIC
 STAND 188
 CHAMDOR
 KRUGERSDORP

DATE: JUNE 2014
 DESIGN: ERROL A. CROFT
 DRAWN: ERROL A. CROFT
 CHECKED:
 SCALE: 1:100 - 1:50
 TITLE: ELEVATIONS SECTION B-B

PROJECT No.: 05-06-14

FOR INFORMATION	FOR TENDER	FOR CONSTRUCTION
DRWG.No.: 101	REV.:	.